Drawing number / Rev

P246600/GENE/2/0007-0

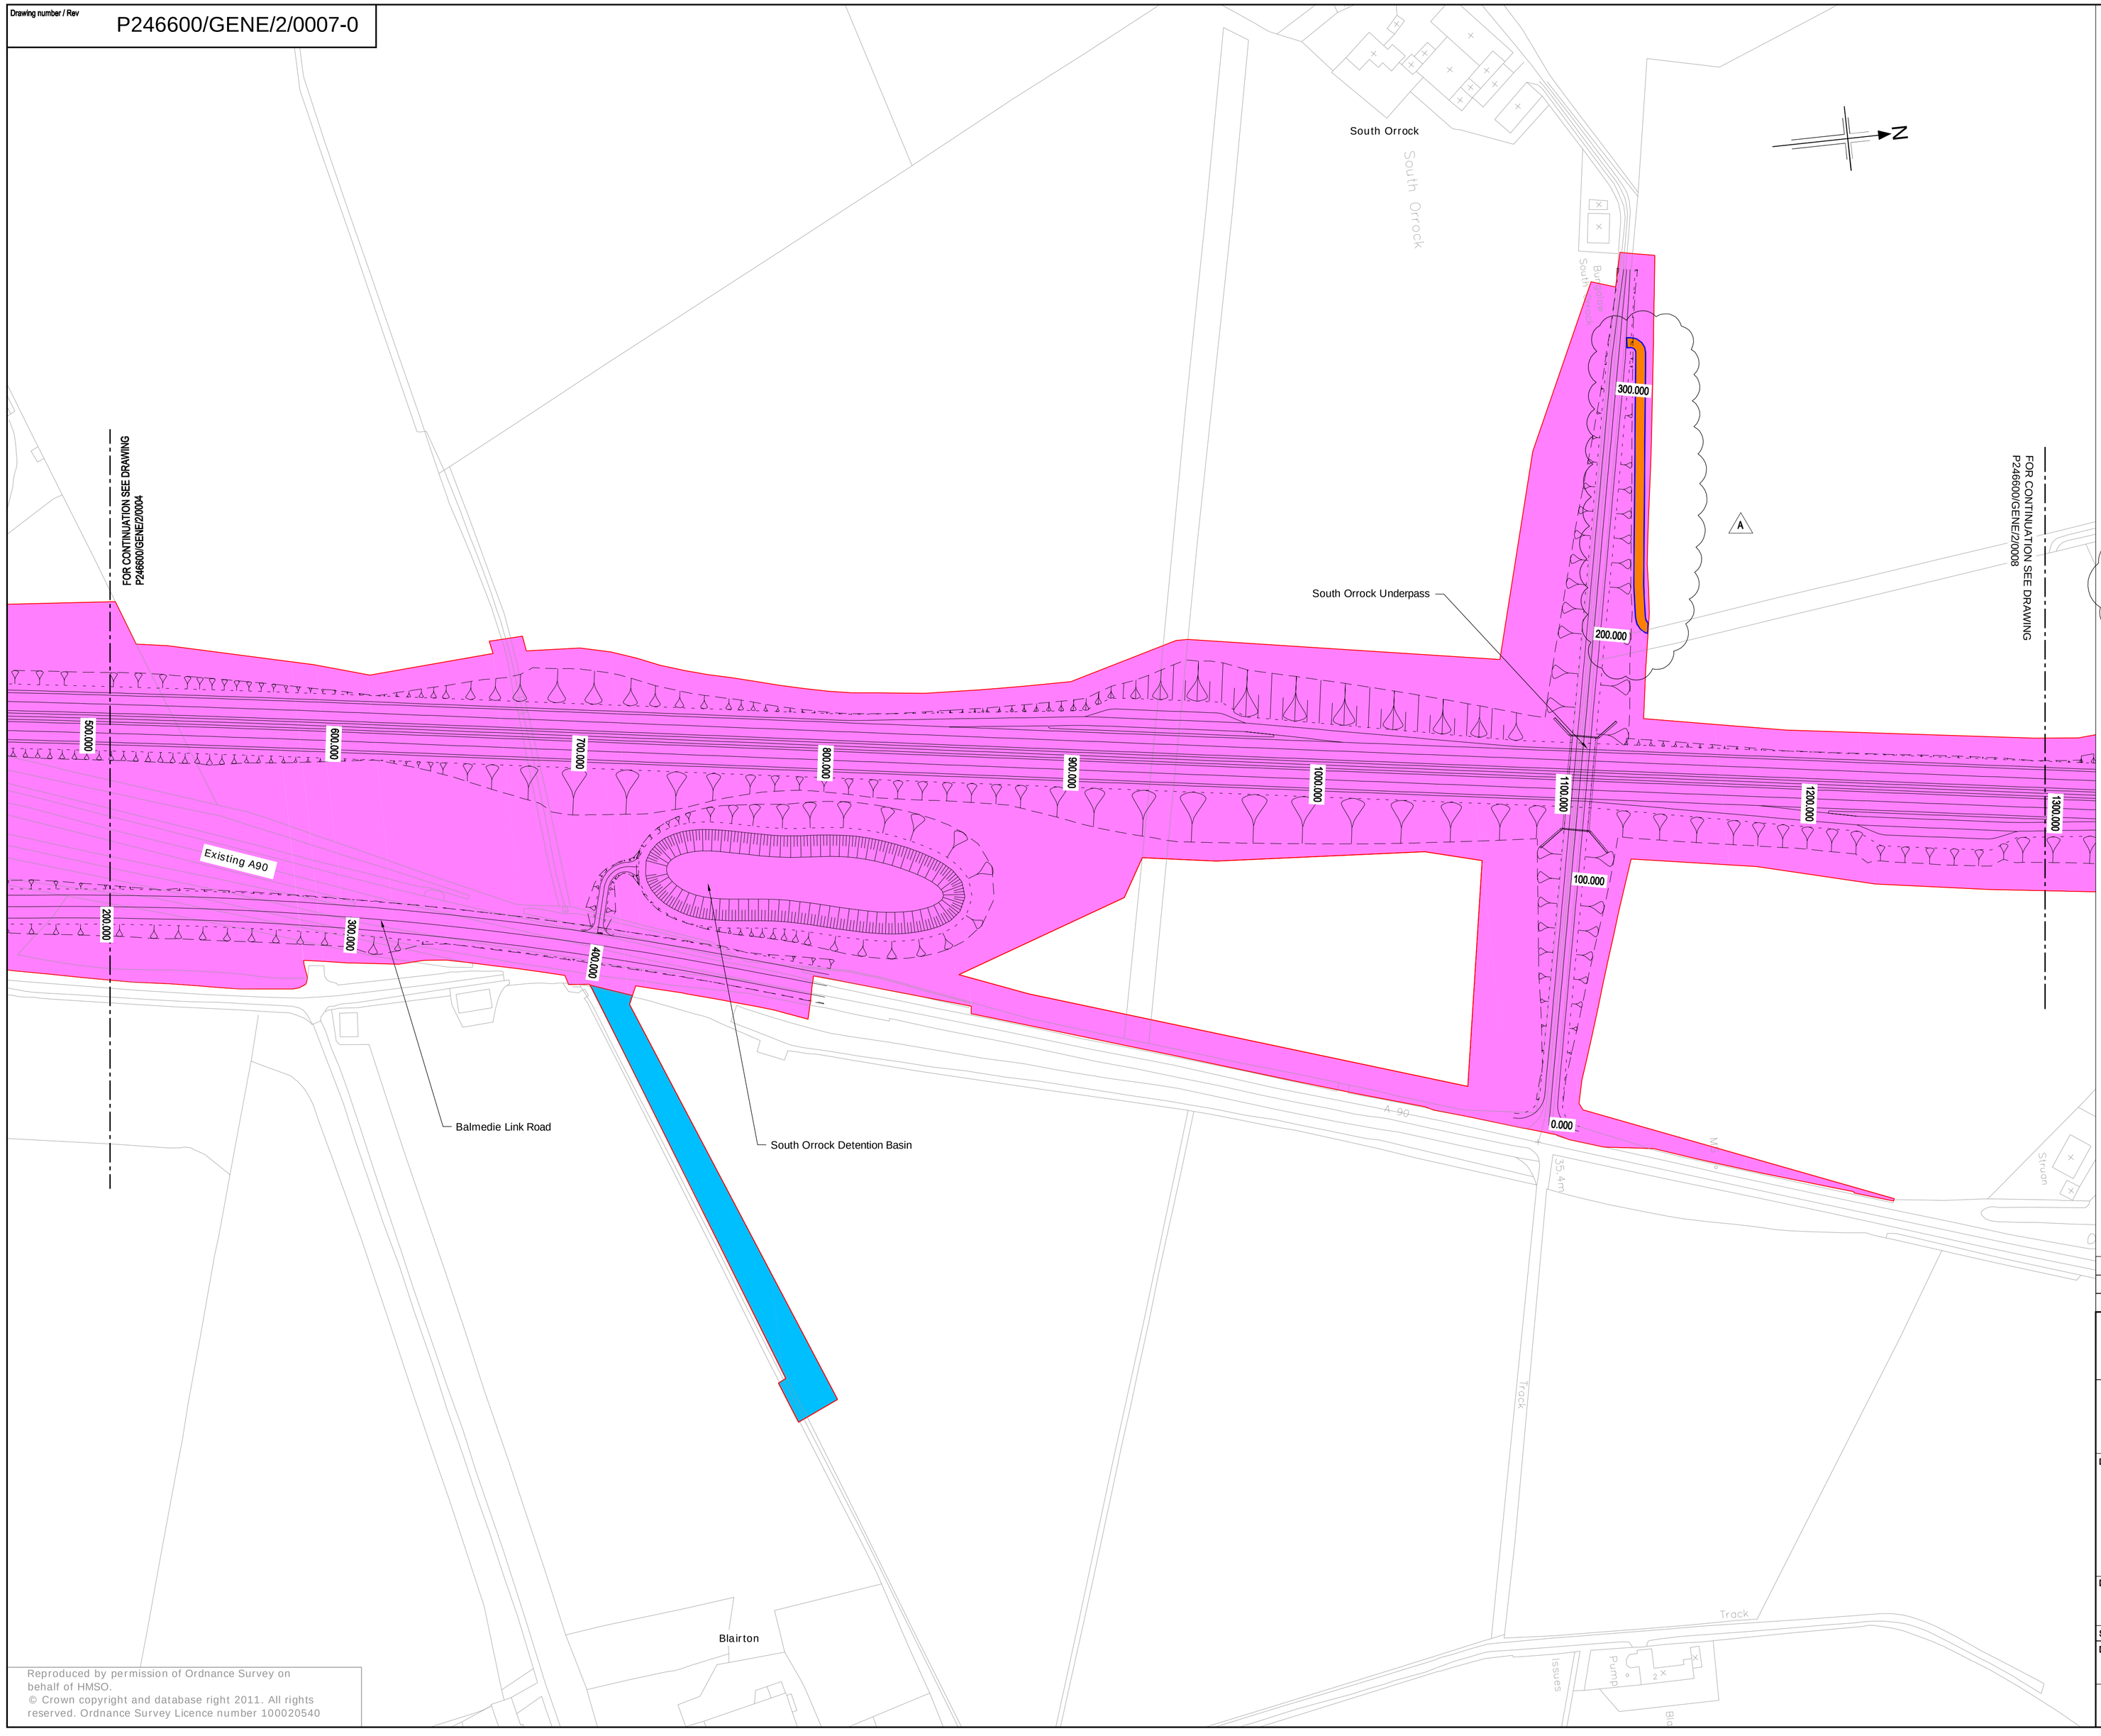

Reproduced by permission of Ordnance Survey on behalf of HMSO.
© Crown copyright and database right 2011. All rights reserved. Ordnance Survey Licence number 100020540

1. This drawing shall only be used for the design element stated in the drawing title.
2. Only written dimensions shall be used.
3. All dimensions are in metres unless noted otherwise.
4. For mainline plan & profile drawings please refer to drawings P246600/GEOM/2/0101-0108
5. For sideroad plan & profile drawings please refer to drawings P246600/GEOM/2/0109-0120
6. For slip roads plan & profile drawings please refer to drawings P246600/GEOM/2/0121-0123
7. For fencing drawings please refer to drawings P246600/FENC/2/0301-0319
8. For RRS drawings please refer to drawings P246600/RRS/2/0401-0419
9. For drainage drawings please refer to drawings P246600/DRAI/2/0501-0519
10. For earthwork drawings please refer to drawings P246600/EART/2/0601-0608
11. For traffic signs and road markings drawings please refer to drawings P246600/SIGN/2/1201-1219
12. For motorway communication drawings please refer to drawings P246600/COMM/2/1501-1515
13. For landscape drawings please refer to drawings P246600/ENVI/2/3001-3019

LEGEND:

Non-Exclusive Availability

Limit of Land Made Available by The Scottish Ministers for the New Works shown shaded pink and bounded by a red line including the red line.

Restricted Availability

The Access Rights over those parts of the New Works Site shown shaded light blue and bounded by a red line including the red line shall be restricted to servitude rights or wayleaves for the purposes of construction and maintenance of drainage works and associated works only.

Third Party Rights

Vehicular Rights of Access across Land Made Available for New Works as shown shaded orange and bounded by a dark blue line including the dark blue line.

IMPORTANT

HEALTH, SAFETY & ENVIRONMENTAL INFORMATION

IN ADDITION TO THE HAZARDS AND RISKS NORMALLY ASSOCIATED WITH THE TYPE OF WORK DETAILED ON THIS DRAWING, PLEASE NOTE THE FOLLOWING SIGNIFICANT RISKS TO HEALTH & SAFETY:-

THE SIGNIFICANT RISKS ASSOCIATED WITH THE PROJECT ARE NOTED BELOW

Ref:	
1	No significant (unusual or expected) risks that a competent contractor would not be aware of are anticipated for Works associated with this design element between the chainage limits of this drawing

REFERENCE RESIDUAL RISK LOG FOR FULL DETAILS REF: P246600/0000/RRL

IT IS ASSUMED THAT ALL WORKS SHALL BE UNDERTAKEN BY A COMPETENT CONTRACTOR WORKING WHERE APPROPRIATE TO AN APPROVED SAFE SYSTEM OF WORK

Rev	Rev. Date	Purpose of revision	Drawn	Checkd	Rev'd	Apprv'd
A	21/01/2014	LMA amendments and changes regarding third party rights	CB	AHB	RL	SAW
0	08/05/2013		SFW	AHB	RL	SAW

Grontmij
2nd Floor
Spectrum House
2 Powderhall Road
Edinburgh
EH7 4GB
Tel : +44 (0)131 550 6300
Fax: +44 (0)131 550 6499
www.grontmij.co.uk

Aberdeen Western Peripheral Route
Balmedie-Tipperty

Drawing title

LAND MADE AVAILABLE BY THE SCOTTISH MINISTERS FOR THE NEW WORKS SHEET 7 OF 19

Drawing status

FOR DIALOGUE

Scale 1:1250@ A1 — DO NOT SCALE

Drawing number P246600/GENE/2/0007 — Rev A

This drawing is not to be used in whole or part other than for the intended purpose and project as defined on this drawing. Refer to the contract for full terms and conditions.