Drawing number / Rev

P246600/GENE/2/0047-A

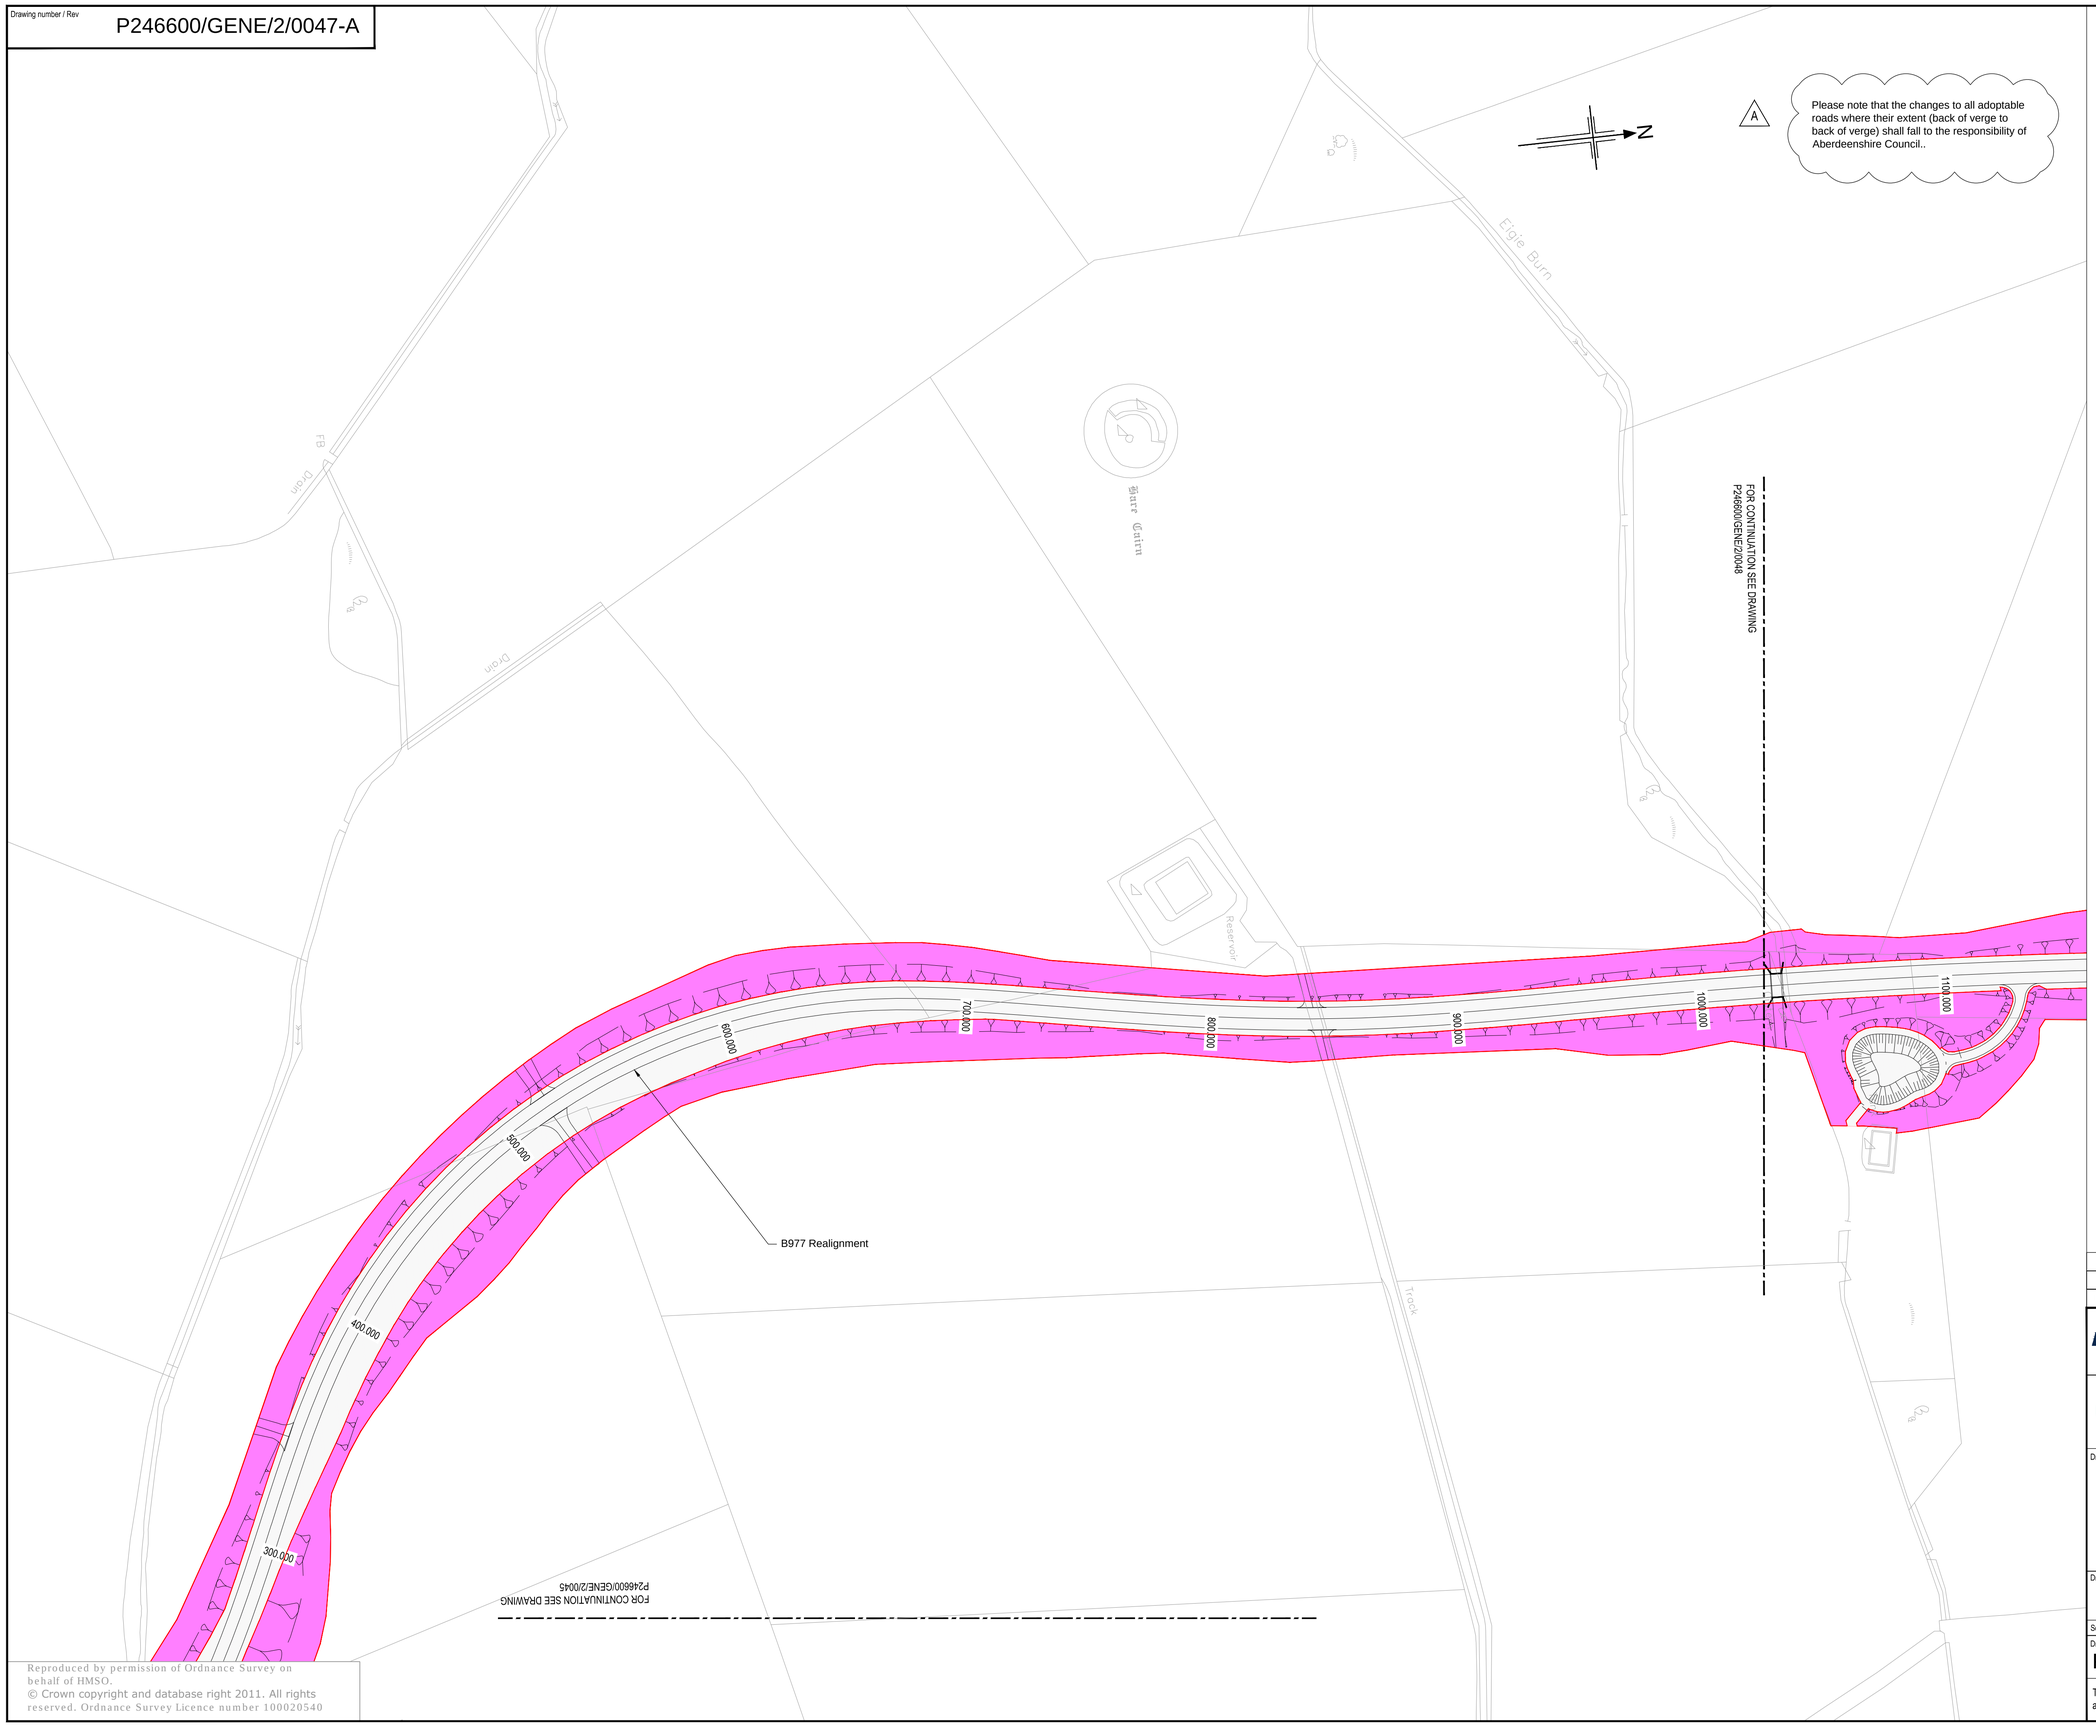

1. This drawing shall only be used for the design element stated in the drawing title.
2. Only written dimensions shall be used.
3. All dimensions are in metres unless noted otherwise.
4. For mainline plan & profile drawings please refer to drawings P246600/GEOM/2/0101-0108
5. For sideroad plan & profile drawings please refer to drawings P246600/GEOM/2/0109-0120
6. For slip roads plan & profile drawings please refer to drawings P246600/GEOM/2/0121-0123
7. For fencing drawings please refer to drawings P246600/FENC/2/0301-0319
8. For RRS drawings please refer to drawings P246600/RRS/2/0401-0419
9. For drainage drawings please refer to drawings P246600/DRAI/2/0501-0519
10. For earthwork drawings please refer to drawings P246600/EART/2/0601-0608
11. For traffic signs and road markings drawings please refer to drawings P246600/SIGN/2/1201-1219
12. For motorway communication drawings please refer to drawings P246600/COMM/2/1501-1515
13. For landscape drawings please refer to drawings P246600/ENVI/2/3001-3019

LEGEND:

Non-Exclusive Availability

Limit of Land Made Available by The Scottish Ministers for the O & M Works shown shaded pink and bounded by a red line including the red line.

Restricted Availability

The Access Rights over those parts of the O&M Works Site shown shaded light blue and bounded by a red line including the red line shall be restricted to servitude rights or wayleaves for the purposes of construction and maintenance of drainage works and associated works only

The Access Rights over those parts of the O&M Works Site shown cross-hatched in green and bounded by a red line including the red line shall be for the purposes of Restricted Services only and shall cease on the Restricted Services completion date.

IMPORTANT

HEALTH, SAFETY & ENVIRONMENTAL INFORMATION

IN ADDITION TO THE HAZARDS AND RISKS NORMALLY ASSOCIATED WITH THE TYPE OF WORK DETAILED ON THIS DRAWING, PLEASE NOTE THE FOLLOWING SIGNIFICANT RISKS TO HEALTH & SAFETY:-

THE SIGNIFICANT RISKS ASSOCIATED WITH THE PROJECT ARE NOTED BELOW

Ref:	
1	No significant (unusual or expected) risks that a competent contractor would not be aware of are anticipated for Works associated with this design element between the chainage limits of this drawing.

REFERENCE RESIDUAL RISK LOG FOR FULL DETAILS
REF: P246600/0000/RRL

IT IS ASSUMED THAT ALL WORKS SHALL BE UNDERTAKEN BY A COMPETENT CONTRACTOR WORKING WHERE APPROPRIATE TO AN APPROVED SAFE SYSTEM OF WORK

Rev	Rev. Date	Purpose of revision	Drawn	Checkd	Rev'd	Appr'd
A	25/09/2013	LMA amendments and changes regarding adoptable side roads	RS	AHB	RL	SAW
0	08/05/2013		SFW	AHB	RL	SAW

Grontmij
2nd Floor
Spectrum House
2 Powderhall Road
Edinburgh
EH7 4GB
Tel : +44 (0)131 550 6300
Fax: +44 (0)131 550 6499
www.grontmij.co.uk

Aberdeen Western Peripheral Route
Balmedie-Tipperty

Drawing title

LAND MADE AVAILABLE BY THE SCOTTISH MINISTERS FOR THE O&M WORKS SHEET 5 OF 24

Drawing status

FOR DIALOGUE

Scale 1:1250@ A1 | DO NOT SCALE

Drawing number: P246600/GENE/2/0047 | Rev: A

This drawing is not to be used in whole or part other than for the intended purpose and project as defined on this drawing. Refer to the contract for full terms and conditions.